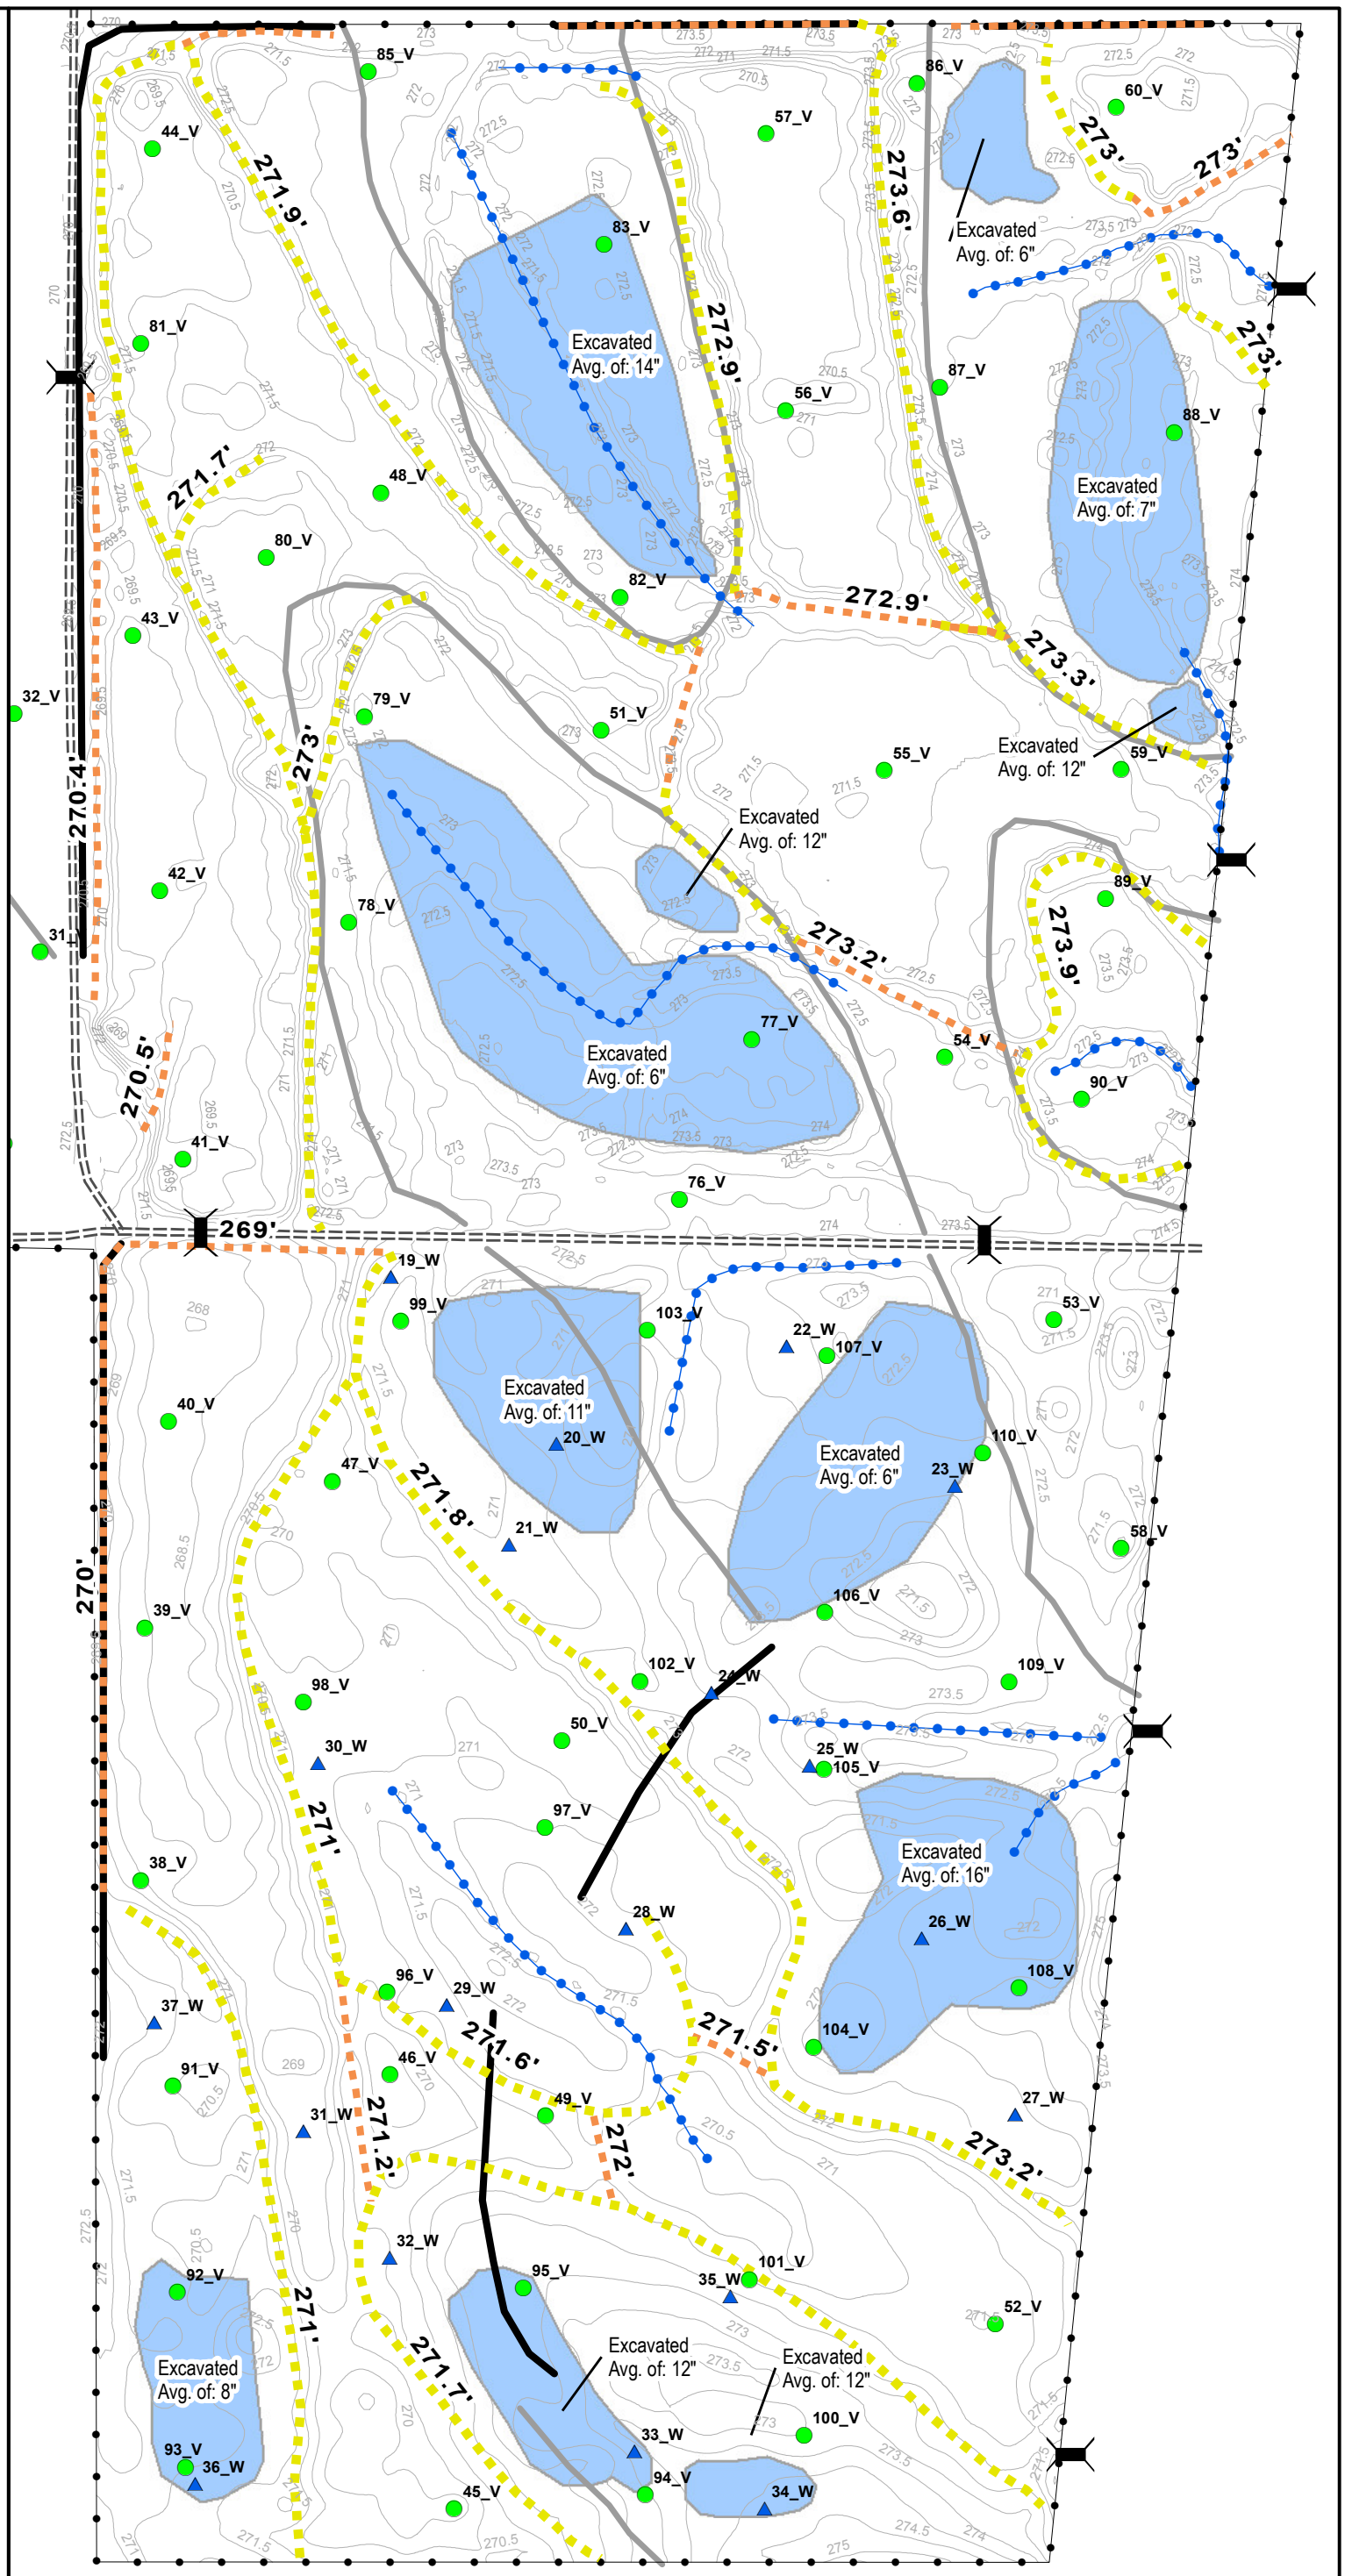

Legend

- ***Existing Culverts***
- ***Constructed Pass Through Channels***
- ***Proposed Constructed Berm***
- ***Proposed Cut and Fill Berm***
- ***As-built Constructed Berm***
- ***As-built Cut and Fill Berm***
- ***Existing Roads***
- ***6" Contour***
- ***Muddy Creek Mitigation Bank Boundary***
- ***Excavated Pool Areas***

N
W E
S

1:1,850

Muddy Creek Mitigation Bank
Phase 2
As-built Map

Benton County, Or. *5/4/2015*

0 50 100 200 300 400 *Feet*

NOTES:

1: All Contours derived with survey grade GPS. Northern phase collected in November 2012 and the southern phase collected in April 2015.

2: Vertical accuracy meets DSL requirements for post-construction surveys. (OAR141-085-0710)